

**SYMBOLS**




**DESCRIPTION**

REGULATED VALVE-IN-HEAD TURF ROTOR TORO MODEL #610 FULL-CIRCLE HEAD  
 REGULATED VALVE-IN-HEAD TURF ROTOR TORO MODEL #640 FULL-CIRCLE HEAD  
 TORO 414-00 QUICK COUPLER VALVE  
 TORO LTC-PLUS SATELLITE CONTROLLER  
 MANUAL CAST IRON RUBBER RING GATE VALVE  
 5" BRASS VALVE FOR GREEN ISOLATION  
 AIR RELIEF VALVE  
 MAIN LINE PIPING, CLASS 200 PVC, SIZE NOTED ON PLAN.  
 SUBMAIN LATERAL LINE PIPING, CLASS 200 PVC.  
 POWER WIRE, SIZE NOTED ON PLAN.  
 WIRE SPLICE  
 POWER SOURCE  
 GOLF IRRIGATION PUMP STATION

**HEAD COUNT**

Fairway Heads  
 218 - Toro 640  
 21 - Toro 610  
 Practice Area  
 36 - Toro 640  
 Greens  
 85 - Toro 610  
 2 - Toro 640  
 Tees  
 15 - Toro 610  
 5 - Toro 640  
**414 Total Heads**  
 254 - Toro 640  
 160 - Toro 610

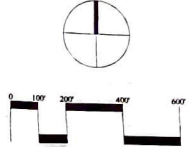

**Irrigation Consultant Services**  
 1377 Business Center Drive  
 Conyers, GA 30094  
 (770) 929-0884 fax (770) 760-8025

**REVISIONS**

No.	Date	Description

**Nob North Golf Course**  
 Cohutta, Georgia

**Irrigation As-Built Plans**

Scale 1"=200'  
 Date 8/28/00  
 Drawn by ICS  
 Checked by ICS  
 Filename 000804ja  
 Sheet

**IR-1**  
 1 of 1